


1 STRIP CENTER SITE PLAN
 SCALE: 1" = 30'-0"

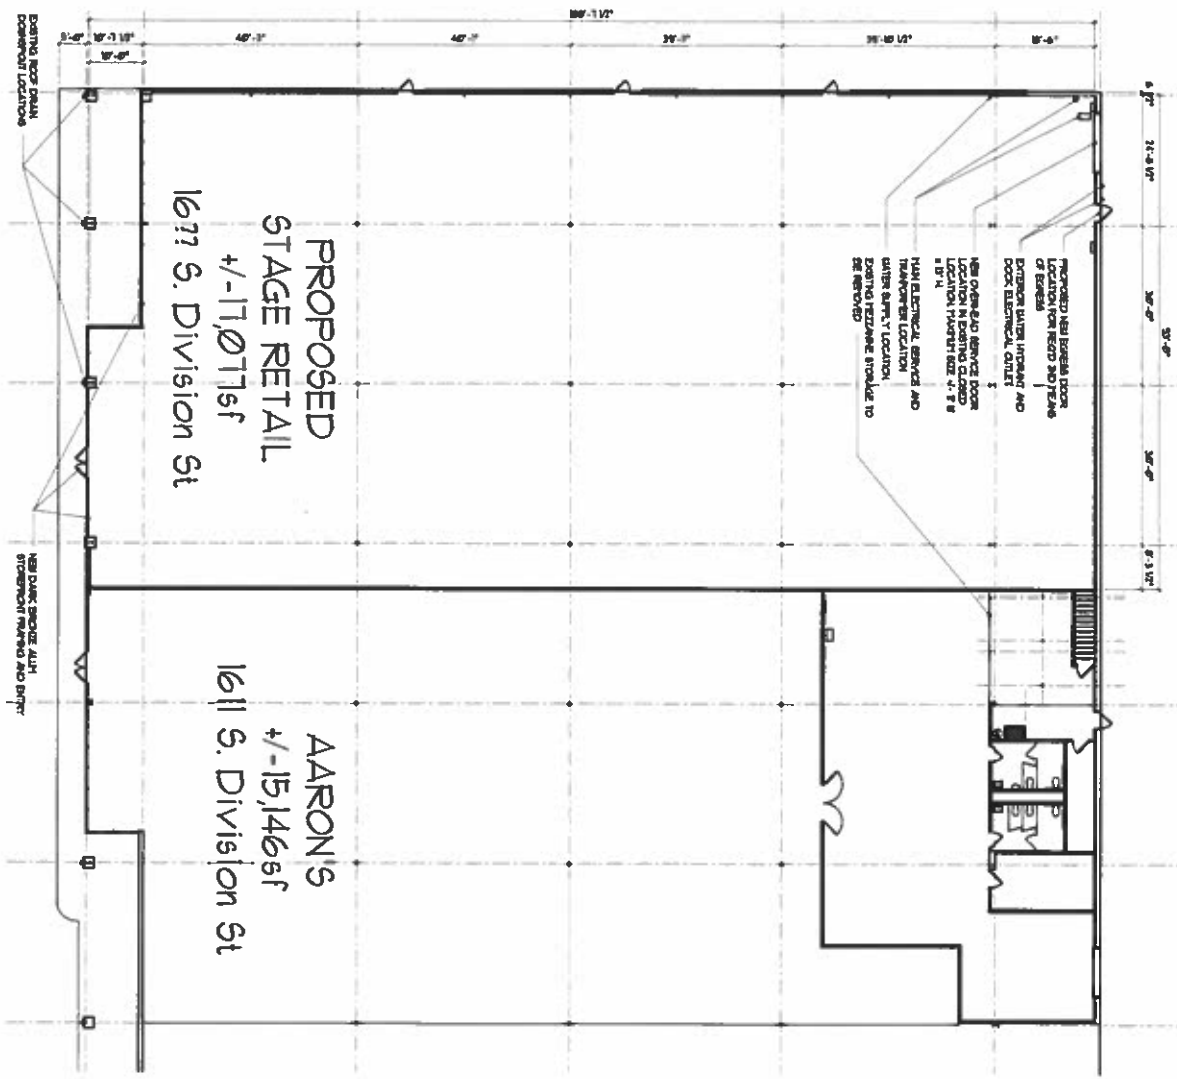


1 PROPOSED NEW STAGE TENANT PLAN
 SCALE 3/8" = 1'-0"

DATE	1/16/20
BY	ML
REVISIONS	NOTED

Guthrie Strip Center As-Built Verification
 Tall Grass Capital LLC
 195-1621 S. Chilton BL
 Okla, Oklahoma

DATE PLOTTED
 1/16/20
 10:23:20A

BWO plc Consulting Architect
 2000 Capital Terrace
 7875
 214-450-2800
 www.bwo-plc.com

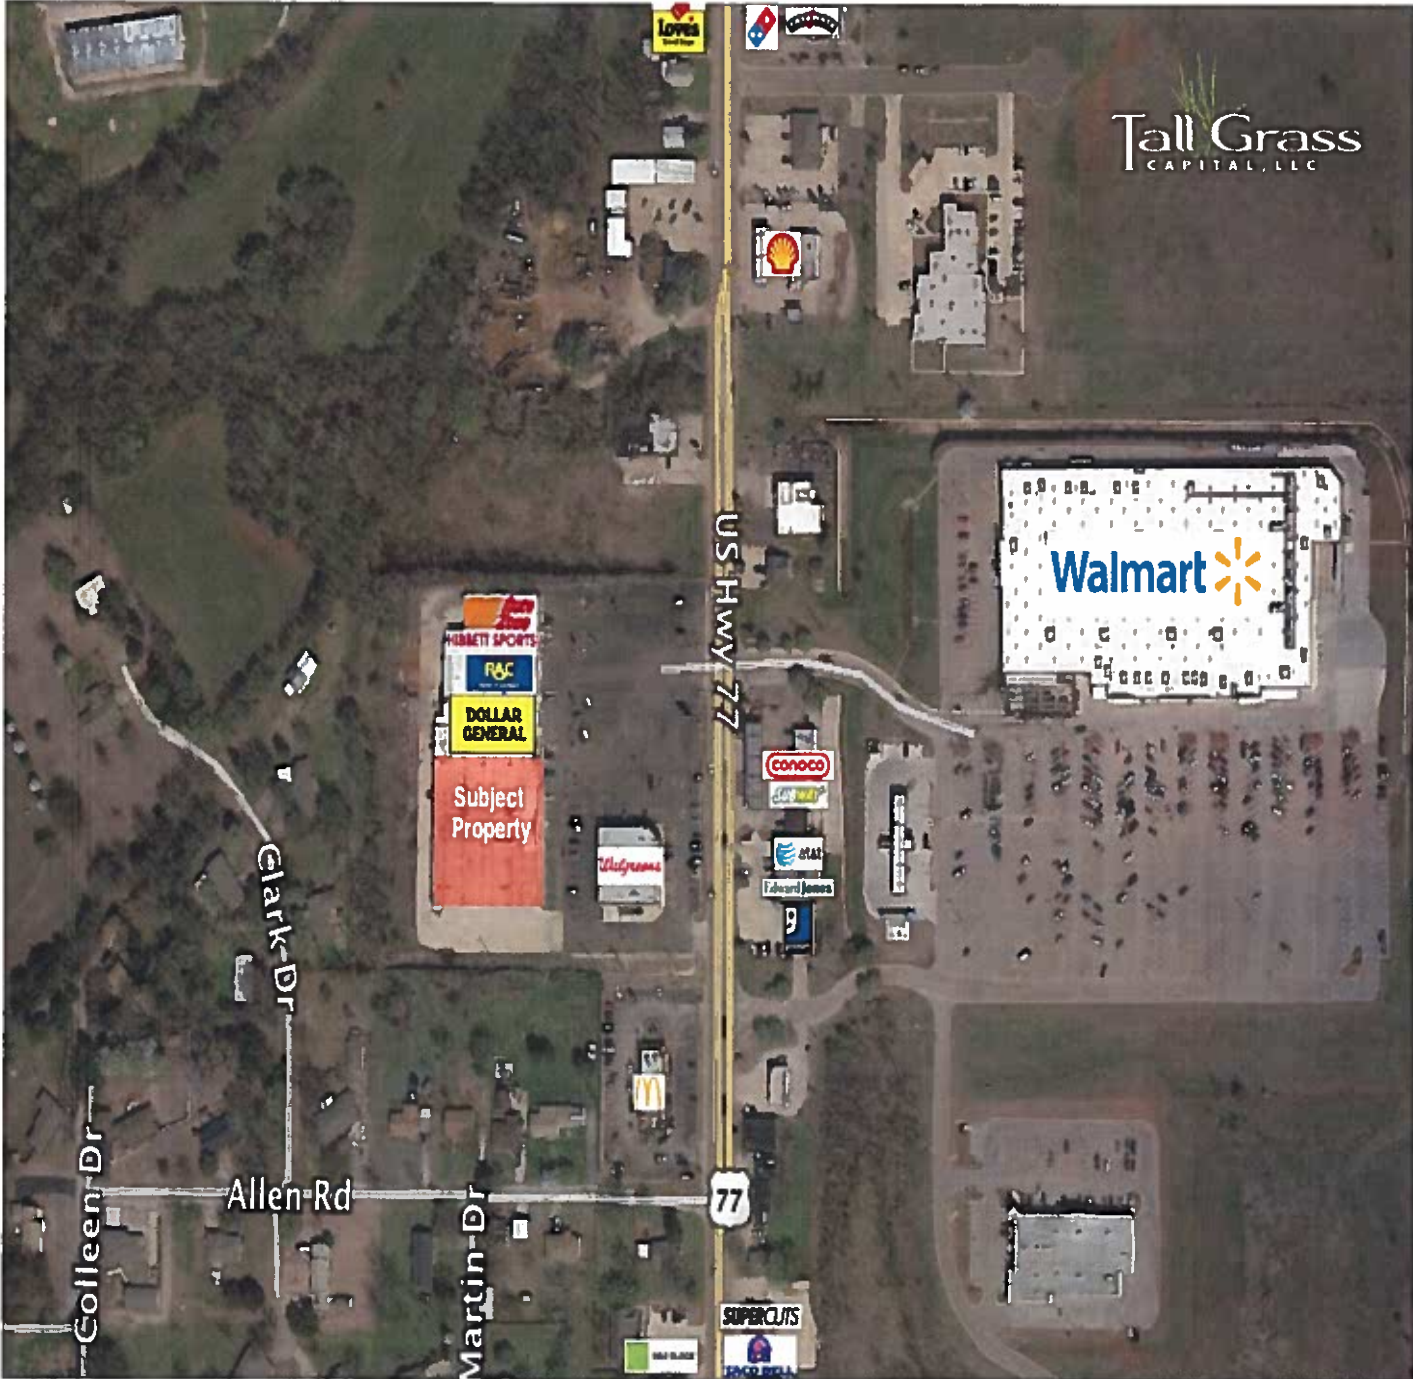

Lowes

Shell

HOBBIETI SPORTS
P&C
DOLLAR GENERAL

Subject Property

Walgreens

Conoco

Starbucks

Edward Jones

Walmart

Colleen Dr

Clark Dr

Allen Rd

Martin Dr

US HWY 77

77

SUPERCLUTS